


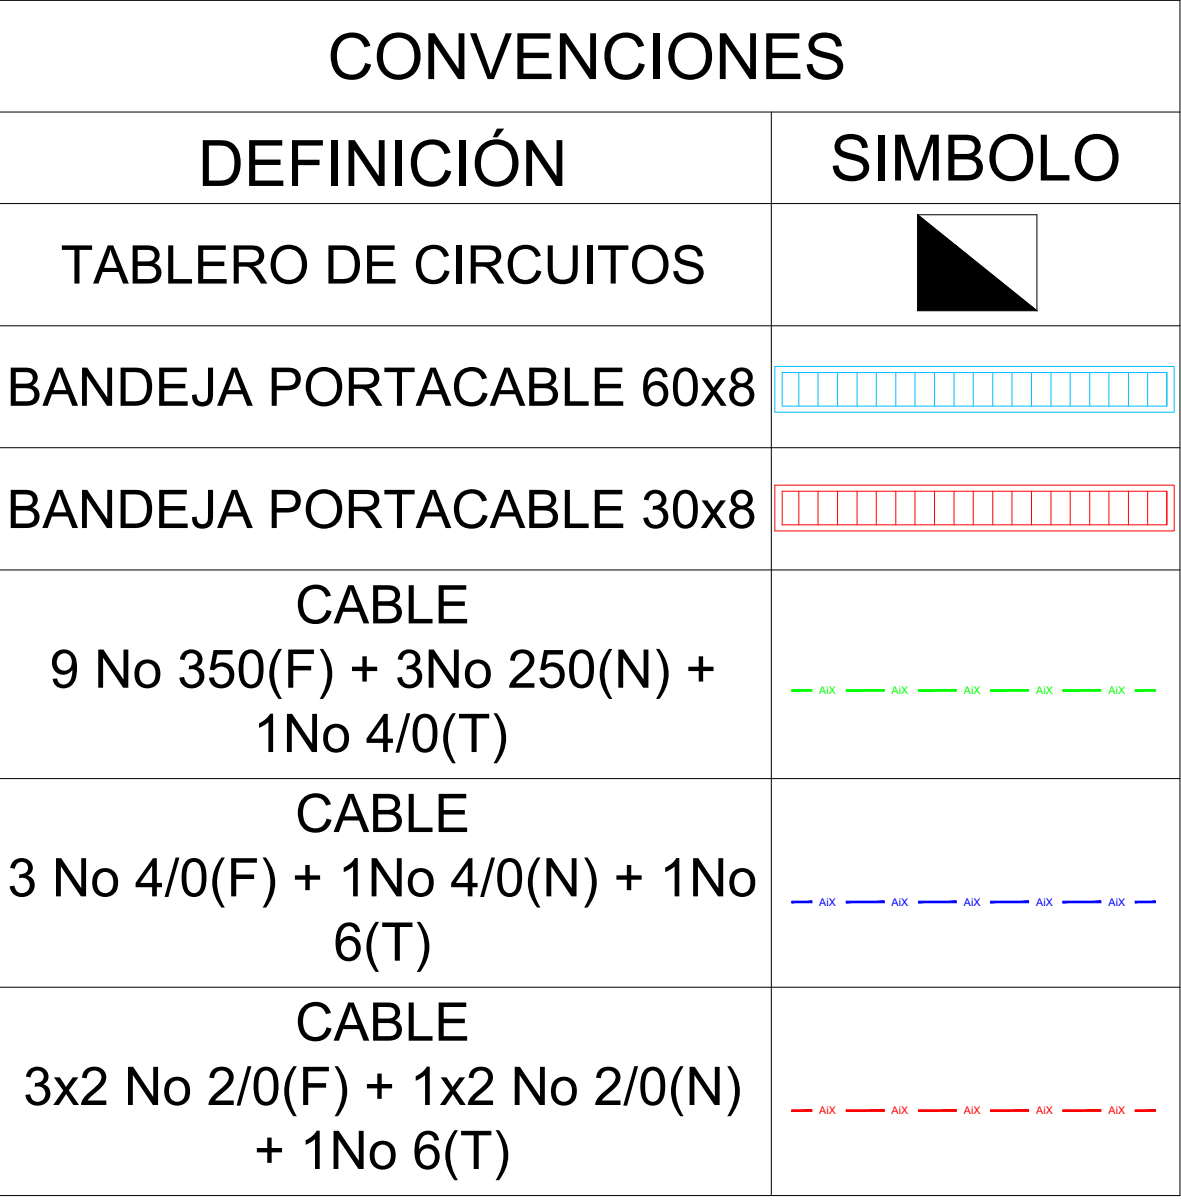

ESCALA 1:20